


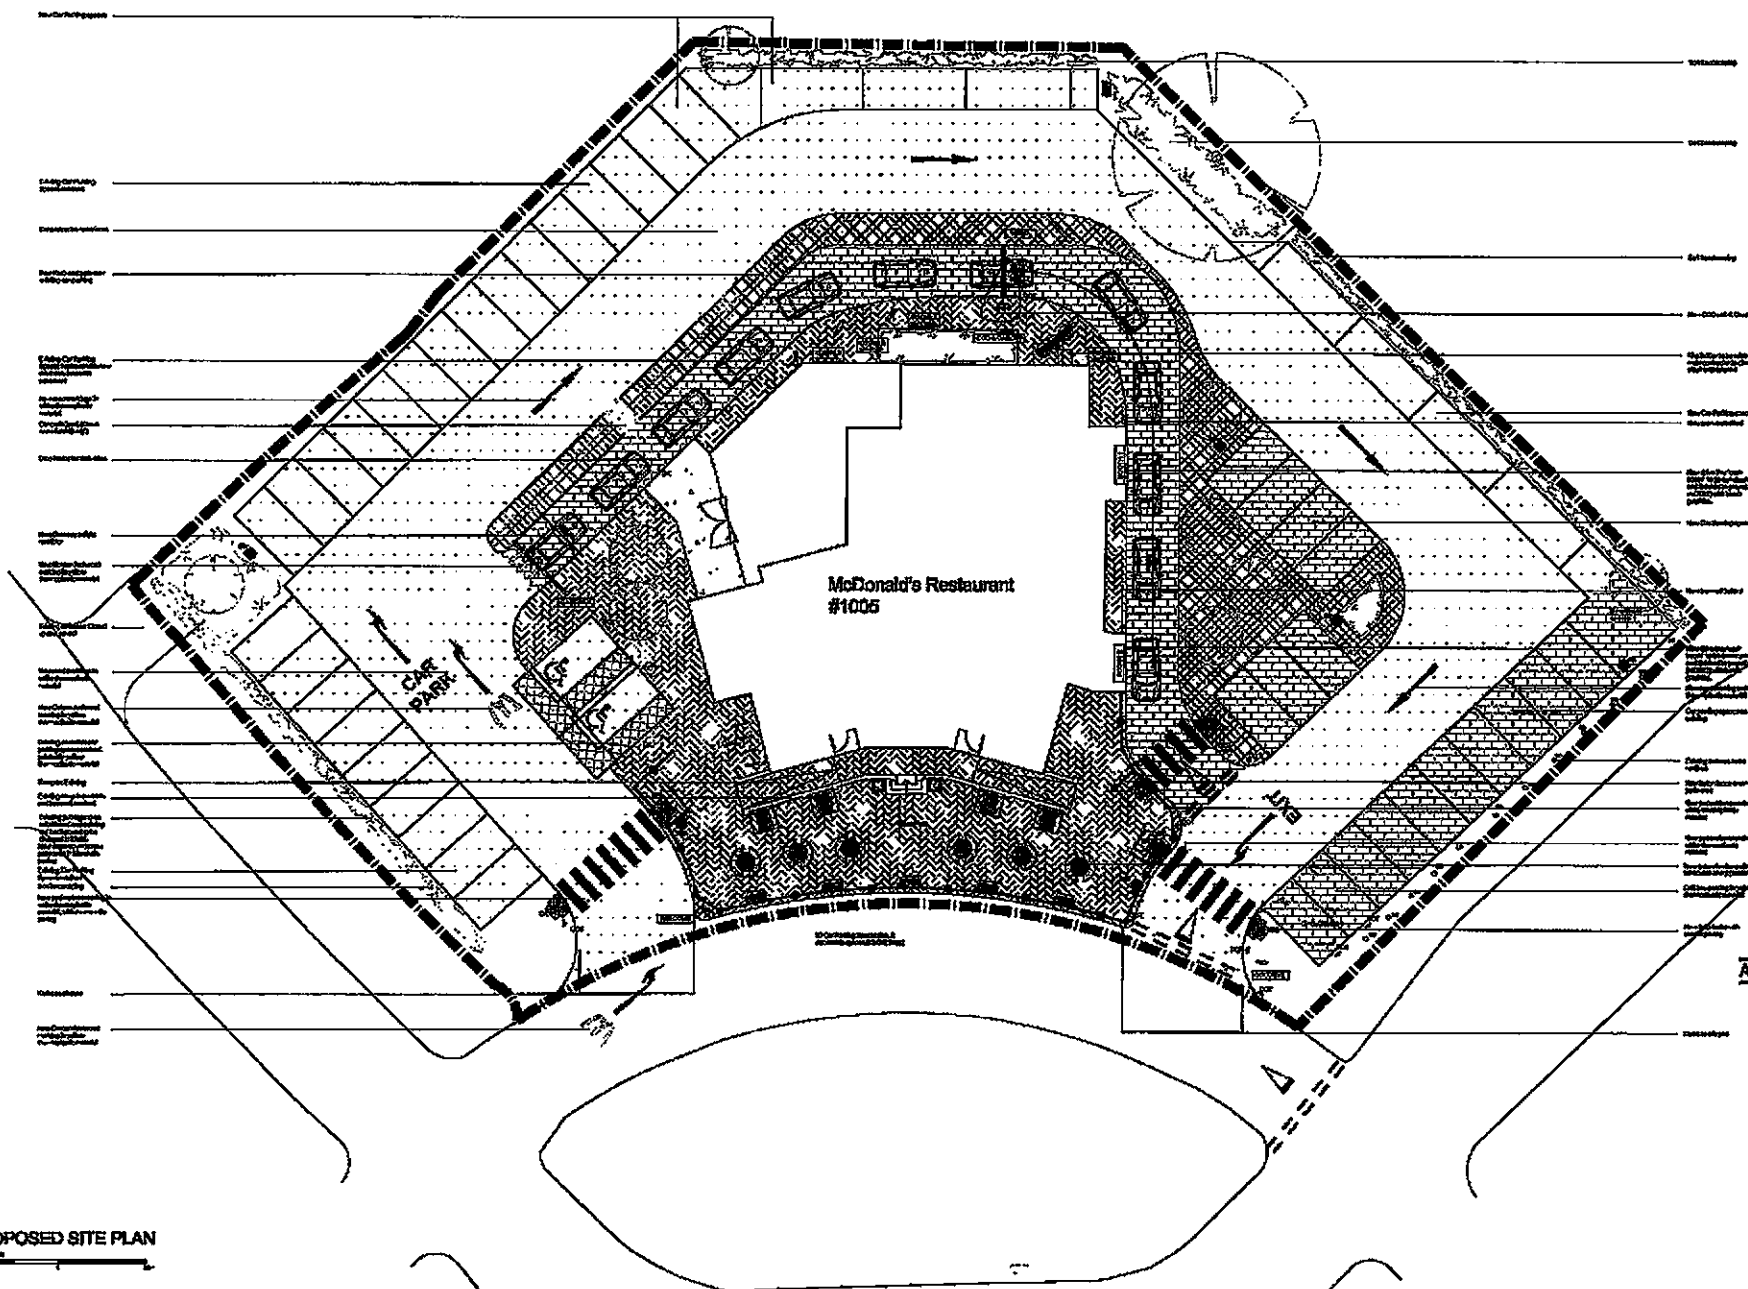

PROPOSED SITE PLAN
McDonald's Restaurant #1005
Date: 10/10/05
Scale: 1/8" = 1'-0"



REVISIONS	
No.	Description

GPLANABT
AS BUILT DRAWING

PROPERTY INFORMATION	
Item	Description

PROPOSED SITE PLAN
Scale: 1/8" = 1'-0"

